

9 June 2016

U140295 – Kopāua (Richmond)

Lauren Kensington  
Marlborough District Council  
PO Box 443  
Blenheim 7240

**Compliance with Condition: Structures**  
**# 12 & 20 Kopāua (Richmond)**

***Location of Structures for Benthic Monitoring Purposes***

12. A corner of (one of) the first marine farm net pen(s) established on the marine farm shall be located on the point nominated for that purpose in Condition 20 and located at one end of either row of the salmon net pens. So long as there remain marine farm net pens on the marine farm, net pens shall be located so as to extend contiguously from the nominated corner in either direction.

**Advice Note:** Condition 12 above is necessary to assist benthic monitoring.

The nominated corner as per Condition 12 above, shall be **Point NE** located on the Farm Layout Plan attached.

***Council to be Informed of Installation of Structures***

20. The Council shall be notified that structures have been installed on the marine farm, and provided with a plan showing the location of those structures, within one month following the initial placement of the first structure(s) at the marine farm, and within one month of the addition of any further structures. When the Council is notified of the initial installation of the first structure(s) on the marine farm, it shall also be informed of the co-ordinates of the starting corner of the marine farm for the purposes of Condition 12.

Our science provider has been made aware of Condition 12 for monitoring.

Can Council please confirm in writing that 'Appendix 1 – OCEL Farm Layout Plan' is acceptable as per conditions above.


Yours faithfully



Mark Gillard  
Environmental Compliance Manager

## **Appendix 1**

OCEL Farm Layout Plan

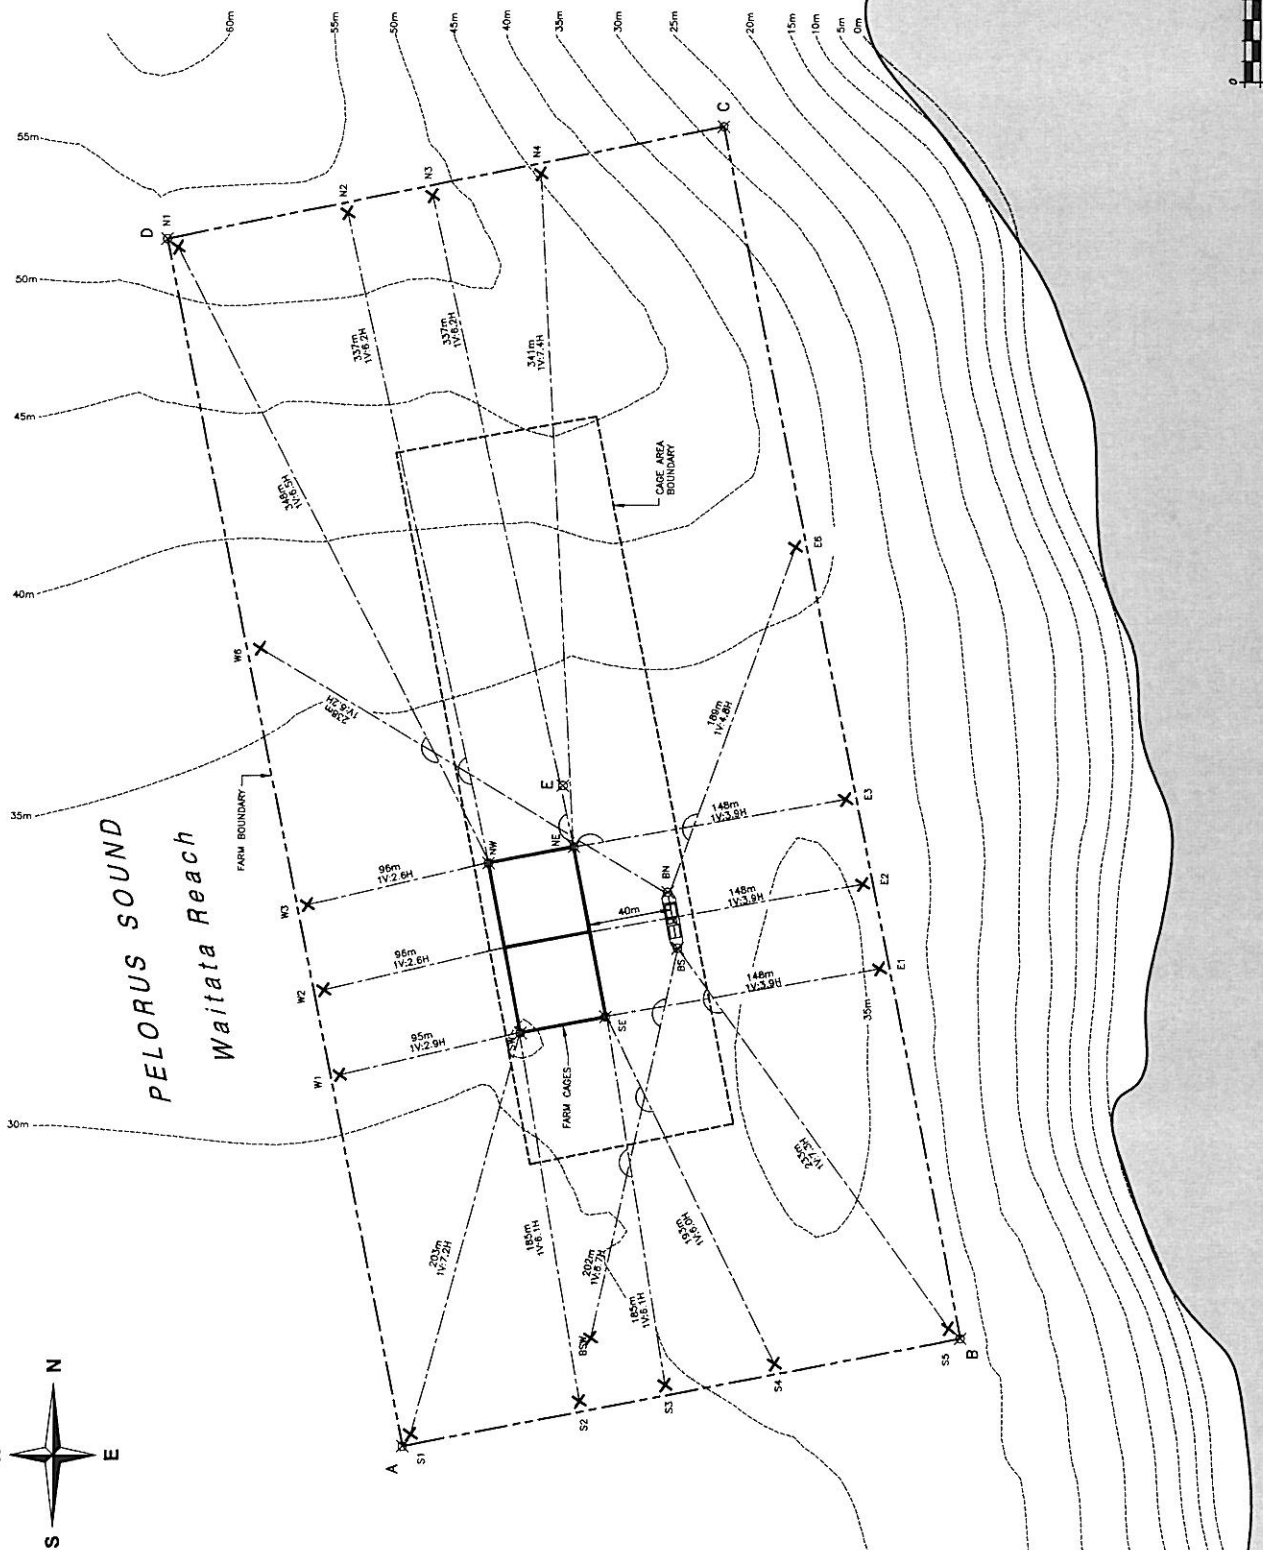

POINT	NZTM		WGS84 (DD MM.mmm)	
	EASTING	NORTHING	LATITUDE	LONGITUDE
A	1,680,942	5,460,909	40° 59.8908' S	173° 57.7439' E
B	1,681,212	5,461,052	40° 59.8605' S	173° 57.8161' E
C	1,681,094	5,461,641	40° 59.4428' S	173° 57.8423' E
D	1,680,825	5,461,586	40° 59.5743' S	173° 57.6589' E
E	1,681,018	5,461,320	40° 59.7169' S	173° 57.7854' E
NW	1,680,982.2	5,461,282.2	40° 59.7237' S	173° 57.7703' E
NE	1,681,033.5	5,461,280.2	40° 59.7238' S	173° 57.7898' E
SE	1,681,039.2	5,461,207.7	40° 59.7774' S	173° 57.6116' E
SW	1,680,998.1	5,461,198.8	40° 59.7819' S	173° 57.7824' E
N1	1,680,930.3	5,461,582.0	40° 59.5764' S	173° 57.6597' E
N2	1,680,912.0	5,461,598.6	40° 59.5869' S	173° 57.7178' E
N3	1,680,953.1	5,461,607.1	40° 59.5821' S	173° 57.7471' E
N4	1,681,005.7	5,461,617.8	40° 59.5560' S	173° 57.7845' E
E1	1,681,171.4	5,461,231.3	40° 59.7839' S	173° 57.9057' E
E2	1,681,162.9	5,461,272.9	40° 59.7417' S	173° 57.8994' E
E3	1,681,154.5	5,461,313.8	40° 59.7195' S	173° 57.8930' E
E4	1,681,128.6	5,461,438.4	40° 59.6533' S	173° 57.8743' E
E5	1,680,945.9	5,461,004.9	40° 59.8976' S	173° 57.7467' E
S1	1,681,027.7	5,461,021.0	40° 59.8784' S	173° 57.8049' E
S2	1,681,088.9	5,461,029.0	40° 59.8238' S	173° 57.8342' E
S3	1,681,121.6	5,461,038.4	40° 59.8679' S	173° 57.8717' E
S4	1,681,205.9	5,461,056.8	40° 59.8860' S	173° 57.9377' E
S5	1,680,910.7	5,461,178.2	40° 59.7938' S	173° 57.7828' E
W1	1,680,902.7	5,461,220.5	40° 59.7713' S	173° 57.7142' E
W2	1,680,894.7	5,461,281.7	40° 59.7491' S	173° 57.7081' E
W3	1,680,871.3	5,461,306.4	40° 59.6819' S	173° 57.6805' E
W4	1,681,032.9	5,461,051.7	40° 59.8618' S	173° 57.8084' E
W5	1,681,088.8	5,461,286.3	40° 59.7445' S	173° 57.8332' E
W6	1,681,073.8	5,461,241.1	40° 59.7592' S	173° 57.8361' E

NOTE:  
1. HYDROGRAPHIC INFORMATION HAS BEEN SOURCED FROM CANTHURON INSTITUTE. DEPTHS ARE BELOW MEAN SEA LEVEL.

LEGEND  
211m LENGTH OF WARP FROM BOTTOM OF SCREW ANCHOR (ASSUMED INSTALLATION DEPTH 6m) TO CAGE  
1V:3.3H SLOPE OF ANCHOR WARP  
X SCREW ANCHOR  
--- FARM BOUNDARY  
--- CAGE BOUNDARY  
--- ANCHOR WARP



AS BUILT

NEW ZEALAND KING SALMON LIMITED		CONSULTANTS NZ LIMITED		Scale (AS)		ACAD Filename	
RICHMOND, WAITATA REACH, PELORUS SOUND		49 Crown Hill Street PO Box 181 Auckland Tel (09) 5760444 Fax (09) 512310		1:2500		8013/JR-0110-0707	
PROPOSED 40402 FARM LAYOUT		272-276 Anigma Street PO Box 877 Auckland Tel (09) 3790444 Fax (09) 3790339		Drawing No.		Rev.	
				DR-051103-073		17	

DO NOT SCALE FROM DRAWING

Per'n	Date	Drawn	Checked	Approved	Date
17	07/06/16	RVE			
16	05/06/16	RVE	Checked		
15	23/05/16	RVE	Traced		
14	19/04/16	RVE	Approved		
					05/11

Per'n	Date	Drawn	Checked	Approved	Date
17	07/06/16	RVE			
16	05/06/16	RVE	Checked		
15	23/05/16	RVE	Traced		
14	19/04/16	RVE	Approved		
					05/11

CONSULTANTS NZ LIMITED  
49 Crown Hill Street  
PO Box 181  
Auckland  
Tel (09) 5760444  
Fax (09) 512310

The drawing and its content  
are the property of King Salmon  
NZ Limited. Consultants NZ Limited  
any unauthorized use  
without the written consent of King Salmon  
is prohibited.