


Services As Laid Plan



SAMPLE DRAWING ONLY

Existing 150 Council SS main

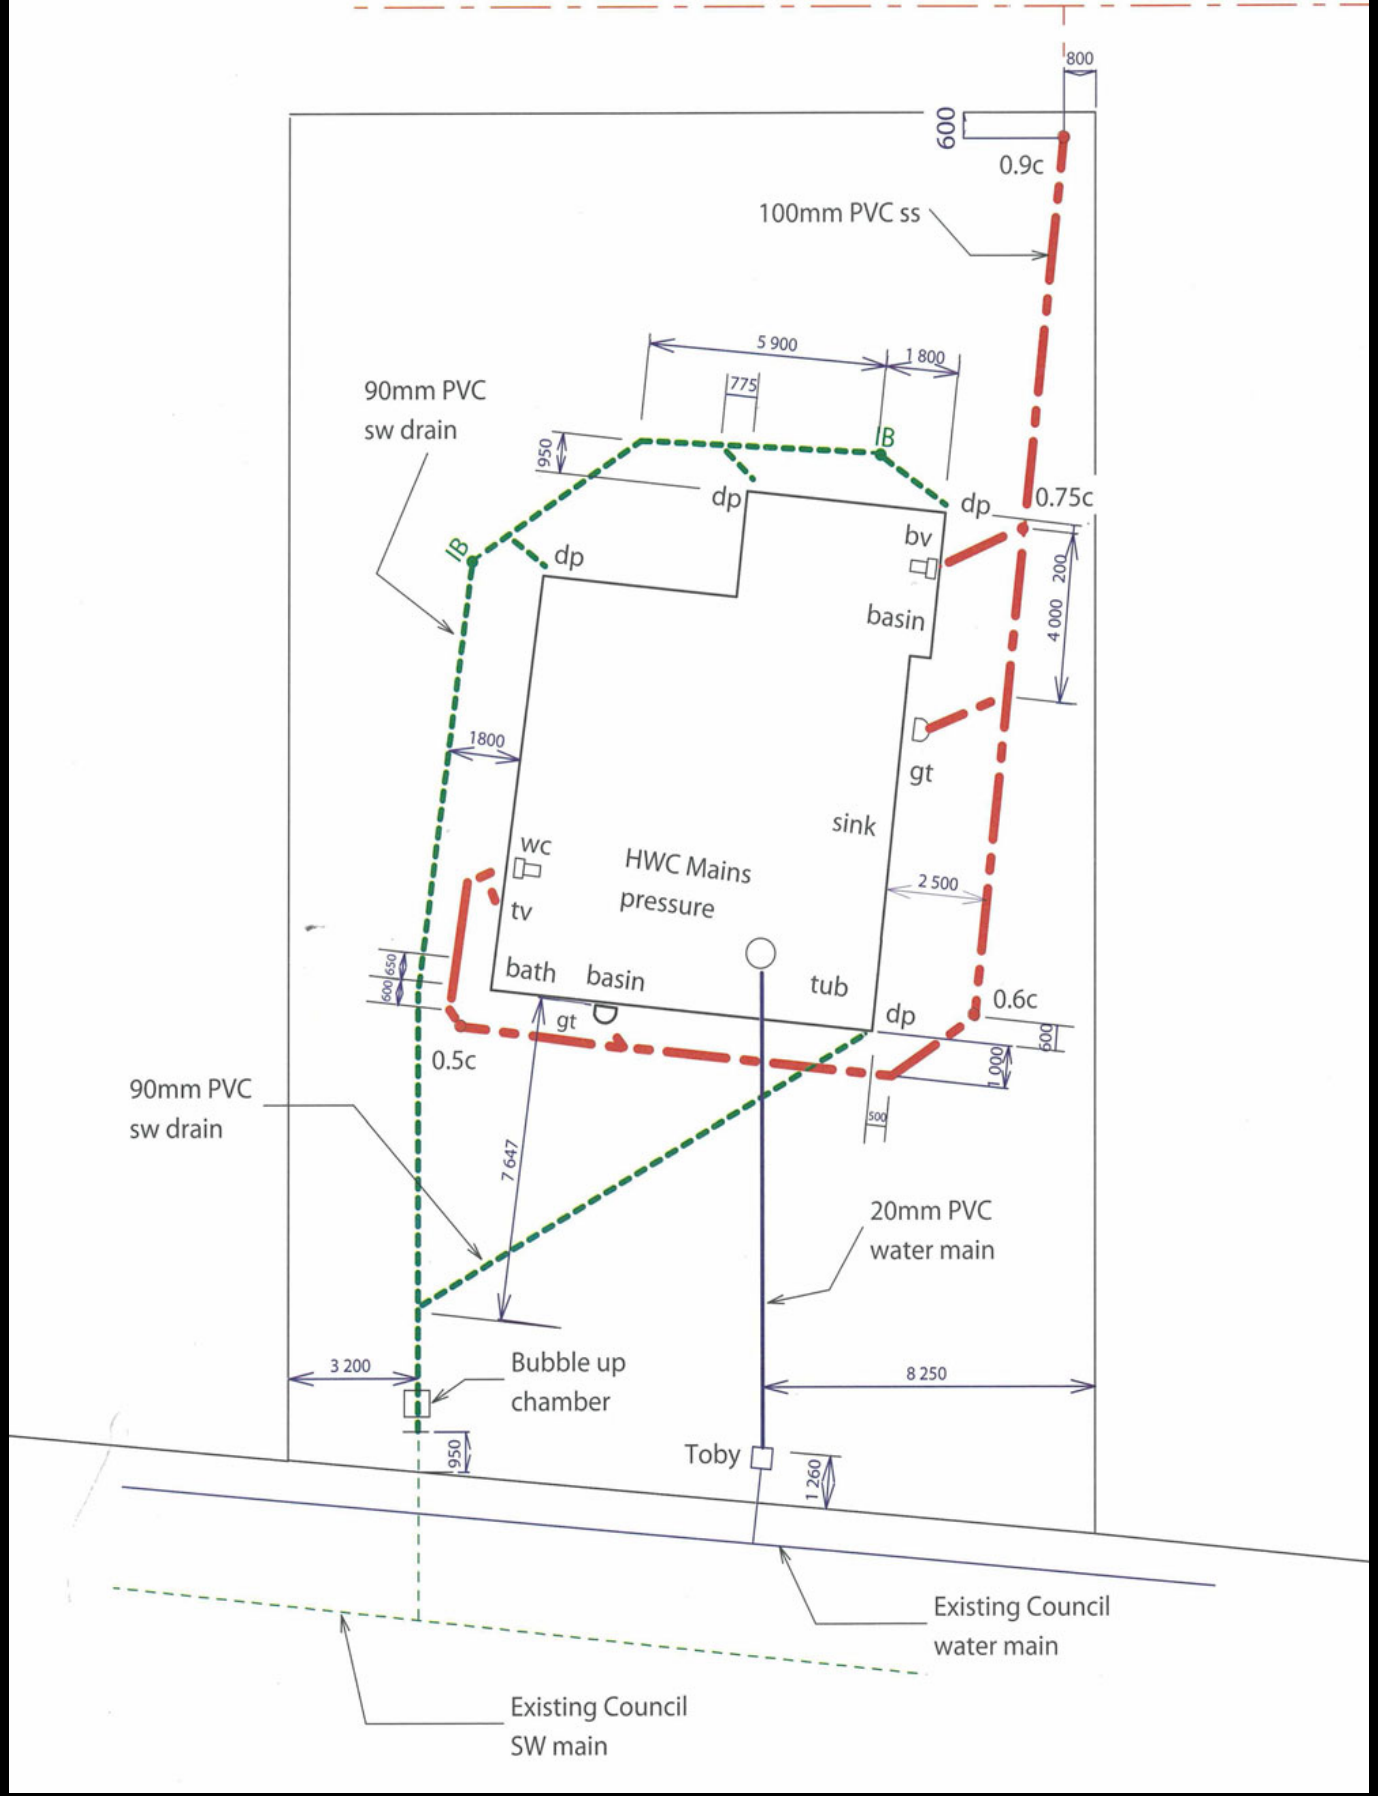

As Laid Plan for Building Consent Number BC

Owner Name: _____

Project Location:
Street Number / Rural ID: _____ Address: _____
Locality: _____

Plumber and Drainlayer Details:
Plumber: _____ Registration Number: _____
Drainlayer: _____ Registration Number: _____

Draw plan in ballpoint on graph section.

1. If drawing in colour use these:

Sewer - red

Stormwater - green

Water - blue

Use these abbreviations:	IY - Inspection Y Junction
SS - Sanitary Sewer	IP - Inspection Pipe
SW - Stormwater	AAV - Air Admittance Valve
GT - Gully Trap	DP - Downpipe
TV - Terminal Vent	MH - Manhole
BV - Back Vent	IC - Inspection Chamber
PV - Pan Vent	BUS - Bubble Up Sump
IB - Inspection Bend	C - Cover

Plan is to show:

2. All drains in correct position relative to building and boundaries. Grade to be indicated.
3. All vents, gully traps and downpipes.
4. The road frontage
5. Depth of drains at connection points and key points such as top end, bottom end and inspections.
6. All foul water and stormwater drains.
7. All inspections opening points accurately dimensioned with at least two measurements.
8. All buildings and boundaries.
9. External main water lines and the source of supply.
10. North pointer or arrow.

Please refer to example on previous page as a guide to requirements.

Office Use Only

Plan Verification

Date of Inspection: _____

Inspector's Name: _____

Inspector's Signature: _____

A large rectangular area filled with a fine grid of small squares, intended for handwritten notes or drawings during the inspection process.